Dart Aerospace Ltd. W/O sprtfu p-3 of any Wednesday, 13/08/2008 10:55:13 AM User Julie Lecocq **Process Sheet** Customer : CC-DAR01 Dart Aerospace Ltd. **Drawing Name** : GLARESHIELD ASSEMBLY Job Number : 41207-2 **Estimate Number** : 13291 P.O. Number : D3690041 **Part Number** : D3690 REVB This Issue : 13/08/2008 . S.O. No. : **Drawing Number** : NC Prsht Rev. **Project Number** : // First Issue Type : SMALL /MED FAB **Drawing Revision Previous Run** : 41018 Material **Due Date** : 01/09/2008 Each Written By Checked & Approved By Comment 08-04-29 new issue DD verified by:ec : Est Rev:A Est Rev:B 08-07-14 revB as per dwg DD verified by:ec **Additional Product** Job Number: **Machine Or Operation:** Seq. #: Description: 1.0 PACKAGING 1 PACKAGING RESOURCE #1 Comment: PACKAGING RESOURCE #1 Pick Packing Kit D36901 2.0 Glareshield Comment: Qtv.: 3.0000 Each(s) 1.0000 Each(s)/Unit Total: Glareshield 3.0 D3697041 Comment: Qty.: Total: 3.0000 Each(s) 1.0000 Each(s)/Unit **Tube Assembly** 08/09/08 batch: 4066 D36981 4.0 Comment: Qty .: 1.0000 Each(s)/Unit 3.0000 Each(s) Total: Support Angle : 4.000 batch: 341022 B41656 5.0 AN960JD3 Comment: Qty.: 6.0000 Each(s)/Unit Total: 18:0000 Each(s) 24000 Washer FF 08/09/08 batch: 77/6

## Dart Aerospace Ltd

W/O:		WORK ORDER CHANGES									
DATE	STEP	PROCEDURE CHANGE	В	By Date	Qty	Approval Chief Eng / Prod Mgr	Approval QC Inspector				
							,				
				·							
			· .								

Part No:	D3690-041	PAR #:	Fault Category:	NCR: Yes No	DQA:	Date:
				QA: N/C C	losed:	Date:

NCR:41	207	Wo	ORK OR	DER NON-CONFORMANCE	(NCR)			
		Description of NC		Corrective Action Section B		Verification	Approval	Approval
DATE	STEP	Section A	Initial Chief Eng	Action Description  Chief Eng	Sign & Date	Section C	Chief Eng	QC Inspecto
රලි පවට පිට	110	All D3698-1 B41022		scraps distray the				1
		B 40666 Angles me scrap.		D3698-1 B-11022, And	SB			
		2 03690-04150 were drilled		Pull from stock & MOCKET	\$ 158/29		//	
		to try and in stall the 03698-1	Jasims	sump.		1209-03	Jusius	fosiur
		R.C. error on the rangles was never noticed, and part was curving inside the	1	See NCR 08-080.			1	1
		S. SU dimension, and parts			82/08/2	1	1651042	2
		were not measured along, as	fosiur	,		108-09-03	1051040	1651042
		Lack of Attention.  Open hole of 129	#	ACCEPTABLE DEMATION	07.09.05		7)	1
53/09/05	8	and Prop Rivet Consultance CR 3213-1-03	: 78	MOSMILLIAM (	V0.104.03		Jasimi	for one

Instead Rivet MS 20170AD 3-5
NOTE: Date & initial all entries

Date:			08/2008 10:55:13 AM				
User:	Julie	Lecocq		Proce	ss Sheet		
Custo	omer:	CC-DAR01	Dart Aerospace Ltd.	·	Drawing Name: GLARE	SHIELD ASSEMBLY	
•		•		,		<del></del>	
· Job Nur	mber:	41207		•	Part Number: D36900	<b>141</b> ×	
Job Number	r:						
				1			
C #				_//		· ·	
Seq. #:			Or Operation:	1/06-09-09	Description	<u> </u>	
6.0		MS20426AL	04-4 HIIIIIIIIIIIIIIIIIIIIIIIIIIIIIIIIIII	RIVET		1 1 <b>3 6</b> 111 <b>1 6 1</b> 11 1 <b>1 6</b> 1	(P//)
	•			<b>,</b> .			$( \ \ \ \ \ )$
Co	ommei	nt: Qty.:	2.0000 Each(s)/Unit	Total: <u>6</u> .9000 Eac			
		RIVET	2.0000 Each(5)/One	Book		0/-	10
		batch:_	M105978	)	FF	00/09,	108
.7,81		MS20470AE	Ca	3213-4-Bivet, Univ	rersal Head		
				3213-4-8ivet,Univ	08.09.05		
1/:							(10)
Co	ommei			Total: 105.0000 Ea			
		-	niversal Head	M16896 ,#	08.05.05	FF. 08/0	a ( - S) ( -
8.0	·	SMALL FAE	1715541		MEDIUM FAB RESOURCE 1	11.300	9/00
0.0	4	SIVIALL FAE	) 	SIVIALL &	WIEDIOW FAB RESOURCE I		
· ;	: ·				,		
Co	ommei	nt: SMALL	& MEDIUM FAB RES	OURCE 1		1100101 (1001 (1001 1001	
	.•					- /	, , }
	<u> </u>	1- transf	fer drill D3697-041 and	d D3698-1 in D3690-1 a	and assemble as per dwg	D3690 FF 001	04/00
9.0	7.	QC5		INSPECT	WORK TO CURRENT STEP		(2)
i .							( P/9
	<u>:</u>		<u> </u>				
	ommei		T WORK TO CURRE		00	E(09/08 (+3)	
10.0		PACKAGING	ë 1 	PACKAGI	NG RESOURCE #1		
				41185			BX)
Co	ommer	nt: PACKA	GING RESOURCE #1	410(1	-4/-		
		Identify	wiith Dart part # and b	atch # using a fine poin	t permanent marker on in	nside of part and Stock	
		Location	1:		,	*1916	Sia
11.0		QC21		FINAL INS	SPECTION/W/O RELEASE		7 1
							1 01/2 14
						<u> </u>	109/110 9
Co	ommer	nt: FINAL II	NSPECTION/W/O REI	LEASE			
Job Completion	n	1880	   <b>                                   </b>	i(   <b>111</b>			
		,				Wolo9-1	< l
10.0 .	20) ا	~ \ \ .	D	/		1, 101-1	)
10.0 -	. }	_ bento	fy and y	dock	,	V(D)	
							ŀ
						•	

## ✓ Dart Aerospace Ltd

W/O:		WORK ORDER CHANGES									
DATE	STEP	PROCEDURE C		Ву	Date	Qty	Approval Chief Eng / Prod Mgr	Approval QC Inspector			
660903	7.0	MS2040AD3-5 me required  porm stronge : upotate		1	)/A /		62 ~ 9-53	/sc.01.95			
3/01/ed	7.0	replace MS20470AD-3 B-NCL'S CCR271553 Y to CR321: Perm - Clonge & upolite dug D3690 Rev. C.	<del>ris</del> ef	N33	08.01.2		Osion	08-08-15			

Part No: <u>D 3690 - O4</u> PAR #: \_\_\_\_\_ Fault Category: \_\_\_\_\_ NCR: Yes No DQA: \_\_\_\_ Date: \_\_\_\_\_ QA: N/C Closed: \_\_\_\_ Date: \_\_\_\_

NCR:41207	· w	ORK OR	DER NON-CONFORMANCE	(NCR)			
	Description of NC		Corrective Action Section B	••	Verification	Approval	Approval
DATE STEP	Section A	Initial Chief Eng	Action Description Chief Eng	Sign & Dațe	Section C	Approval Chief Eng	Approval QC Inspector
06.04.03	10.6144	ever ly	REPLACE MS 20470.403-5 WITH AS 20470 AD 4-5 FOR THIS W/O ONLY (QTY=1)	02/04/09	0609,05	08.000	10808-09
08.4088.0	PART, The original rivers		Remove: Replace threfolly the 03697-041, pol x 3 1x \$3697-041 B41221 1 x \$3697-041 500p.	8/09/09	080509	foliur	108.09.00
NOTE: Date & init	thole is enlarged around ix  CER 274553-4 rivet, e  Another was chilled and installe  through the original MS20470AD  rivet.  R.C. Lack of attention i conten	3-5 POSIUL	the 03697-041 etgl the 03697-041 etgl Procure B-41021 weld his corefully parasisod Oty 3	08/09/09	06-05:05	Resour	108-05-08

H:\fFORMS\Quality Assurance\approved QA\NCRWO RevD

W/O:		<b>₩ORK ORDER CHANGES</b>					,
DATE	STEP	Perenent James PROCEDURE CHANGE	Ву	Date	Qty	Approval Chief Eng / Prod Mgr	Approval QC Inspector
દક્ષિક	4.1	Spry Pait as per OST 005 4.2. Flat black using Cohascilit 22. MOR 08 09 15	W	08/09/08		102-09-08	० ह्या ० हा ०
ઝિલિક	9.2	Zispect Spril Pait QC14 /08.05.15 2		<del>101/08/08</del>		102-09.08	

Part No: <u>D3690-041</u>	PAR #: MH	Fault Category:	Prod POB. POS' MOL	NCR: (Yes) No	DQA:	Date: 88109 128
D412-776 Resolution:	work	Disposition:		QA: N/C Closed	: <u>D</u>	Date: <u>38/39/39</u>

NCR:	1207	W	WORK ORDER NON-CONFORMANCE (NCR)						
DATE	STEP	Description of NC	Initial	Corrective Action Section B Action Description	Sign &	Verification	Approval	Approval	
		Section A	Chief Eng Chief Eng		Date	Section C	Chief Eng	QC Inspector	
		Holewas stightly over sized when removing the 3-4 rived.		- Replace with a on 2"	8/09/09				
08-0A-09	6.0	when removing the 3-4 rives.		of 4-4 rivets.				//	
			demon	M 1021		10809.15	10009-09	108.09.09	
			164141	and washers ANGGOIDY			051042	1	
		Hole was slightly	[ [ / ]	m 11735					
,		Hole was slightly oversized when removing the 3.5		Perlies with oty 4	85				
	,	and replex	Pascun		Slogles	108 xx.15		1000.15	
		•	( ( ) ( ) ( ) ( ) ( ) ( )	M107822	78(0	708000	Josius	100	
		was how o	1		60				
		ANGROOD3 FOR		AVALOTOBE	B	( / /	(/		
		4~36020°	Assun	H 12085	53/59/39	16409-15	bslus 1	16-09-65	

NOTE: Date & initial all entries

-MS20470AD3-4 RIVET -D3697-041 TUBE ASSEMBLY D3698-1 SUPPORT ANGLE -MS20470AD3-4 RIVET 20 PLS -MS20470AD3-4 RIVET (1) AN960JD3 WASHER (1) 2 PLS PER SIDE -D3690-1 GLARESHIELD -MS20426AD3-4 RIVET (1) AN960JD3 WASHER (1) 1 PLS PER SIDE


## PART LIST

X   D3690-041   GLARESHIELD ASSEMBLY		-041	PART NUMBER	DESCRIPTION
1 D3697-041 TUBE ASSEMBLY 1 D3698-1 SUPPORT ANGLE 6 AN960JD3 WASHER (OR NAS1149DN332J)		х	D3690-041	GLARESHIELD ASSEMBLY
1 D3697-041 TUBE ASSEMBLY 1 D3698-1 SUPPORT ANGLE 6 AN960JD3 WASHER (OR NAS1149DN332J)				
1 D3698-1 SUPPORT ANGLE 6 AN960JD3 WASHER (OR NAS1149DN332J)		1	D3690-1	GLARESHIELD
6 AN960JD3 WASHER (OR NAS1149DN332J)		1	D3697-041	TUBE ASSEMBLY
		1	D3698-1	SUPPORT ANGLE
WITHOUT NOT WITHOUT WI			AN960JD3	WASHER (OR NAS1149DN332J)
MITHOUT NOT	<b>F</b> :		MICCOMPONENTS 4	DIVET
SHOP COPY RETURN TO RETURN TO ENGINEERING ONTROLLED CONTROLLED BJECT TO AMEN WITHOUT NOT	~ ~ ⊃	l 4	M320420AD3-4	ILIAC:
	NCON I	35 ENG	MS20470AD3-4	

## D3690-041 GLARESHIELD ASSEMBLY

В	ADD FI	NISH COAT & 1. N THICKNESS.	0 TYP, SHEET 2 ZONES A,8 & C,5; SHEET 3 ZONE A,8	RF	08.06.24
Α	NEW IS	SUE		RF	08.05.26
REV.	<del></del>				DATE
DESIG	N	RF	DART AEROSPAC	ELI	TD C
DRAW	DRAWN RF		HAWKESBURY, ONTARIO, 6	-	
CHECK	ŒD	a	DRAWING NO.		REV. B
MFG. A	MFG. APPR.		D3690		SHEET 1 OF 3
APPRO	VED	111	TITLE		SCALE
DE API	PR.	4	GLARESHIELD ASSEM	BLY	NTS
DATE	08.0	6.24	COPYRIGHT © 2008 BY DART AERO THES DOCUMENT IS REVATE AND CONFOCKTUA, AND IS BURYARD ON T NOT TO BE USED FOR ANY PURPOSE OR CORPED OR COMMANICATED:	E DURES	OCHDITION THAT IT IS

D

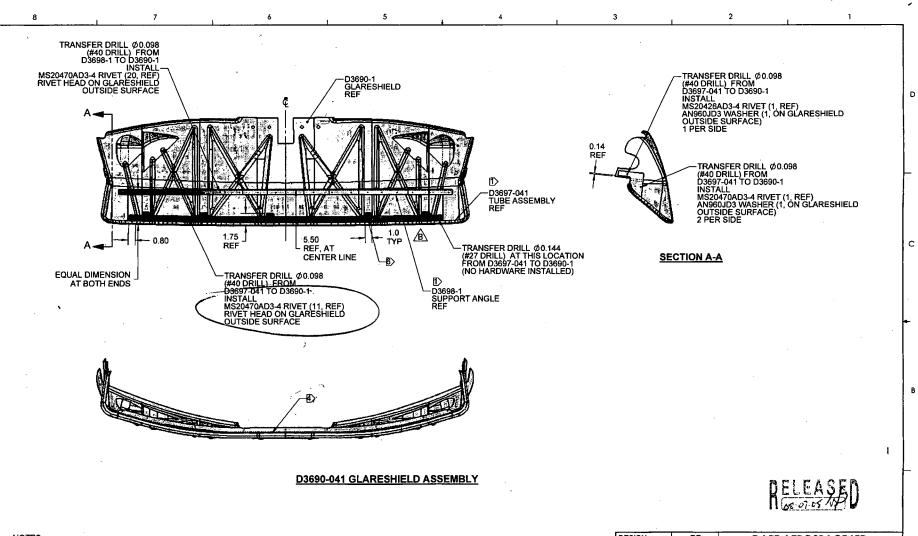

NOTES:
1) CENTER D3697-041 AND D3698-1 ON TO D3690-1
2) FINISH: PAINT D3690-041 ASSY FLAT BLACK USING BASF GLASURIT 22 LINE CODE SFA39.50 PER DART QSI 005 4.2
3) TOLERANCES: PER DART QSI 018 UNLESS OTHERWISE NOTED
4) IDENTIFICATION: ETCH WITH DART P/N D3690-041 & B/N ON INSIDE OF PART
5) WEIGHT: 2.98 lbs
6) MASK HATCHED AREAS (6 PLS) ON INSIDE OF THE PART PRIOR TO PAINTING

DESIGN RF DART AEROSPACE LTD DRAWN RБ HAWKESBURY, ONTARIO, CANADA DRAWING NO. CHECKED REV. B D3690 MFG. APPR SHEET 2 OF 3 APPROVED TITLE SCALE GLARESHIELD ASSEMBLY DE APPR. NTS COPYRIGHT & 2008 BY DART AEROSPACE LTD
THE COCCIONED ROWSHAW AND COMPUTED WITH A COCCIONATE ROWSHAW AND CONTROL OF MOTHER AND THE ROWSHAW AND THE RESIDENCE WITH TO BE USED FOR ANY REPORTED AND COPPED OR COMPUTED TO ANY OTHER RESIDENCE WITHOUT TO BE USED FOR ANY REPORTED ANY OTHER RESIDENCE WITHOUT TO BE USED FOR ANY REPORTED ANY OTHER RESIDENCE WITHOUT TO BE USED FOR ANY REPORTED ANY OTHER RESIDENCE WITHOUT TO BE USED FOR ANY REPORTED ANY OTHER RESIDENCE WITHOUT TO BE USED FOR THE RESIDENCE WITHOUT THE RESIDENCE WITHOUT TO BE USED FOR THE RESIDENCE WITHOUT TO BE USED FOR THE RESIDENCE WITHOUT TO BE USED FOR THE RESIDENCE WITHOUT THE DATE 08.06.24

SHOP COPY
RETURN TO
RETURN TO
RETURN TO
RETURN TO
SUBJECT TO AMENDMENT
SUBJECT TO AMENDMENT
SUBJECT TO AMENDMENT
WITHOUT NOTICE
WITHOUT NOTICE

D

